




1 A Basement (EXISTING)
3/16" = 1'-0"

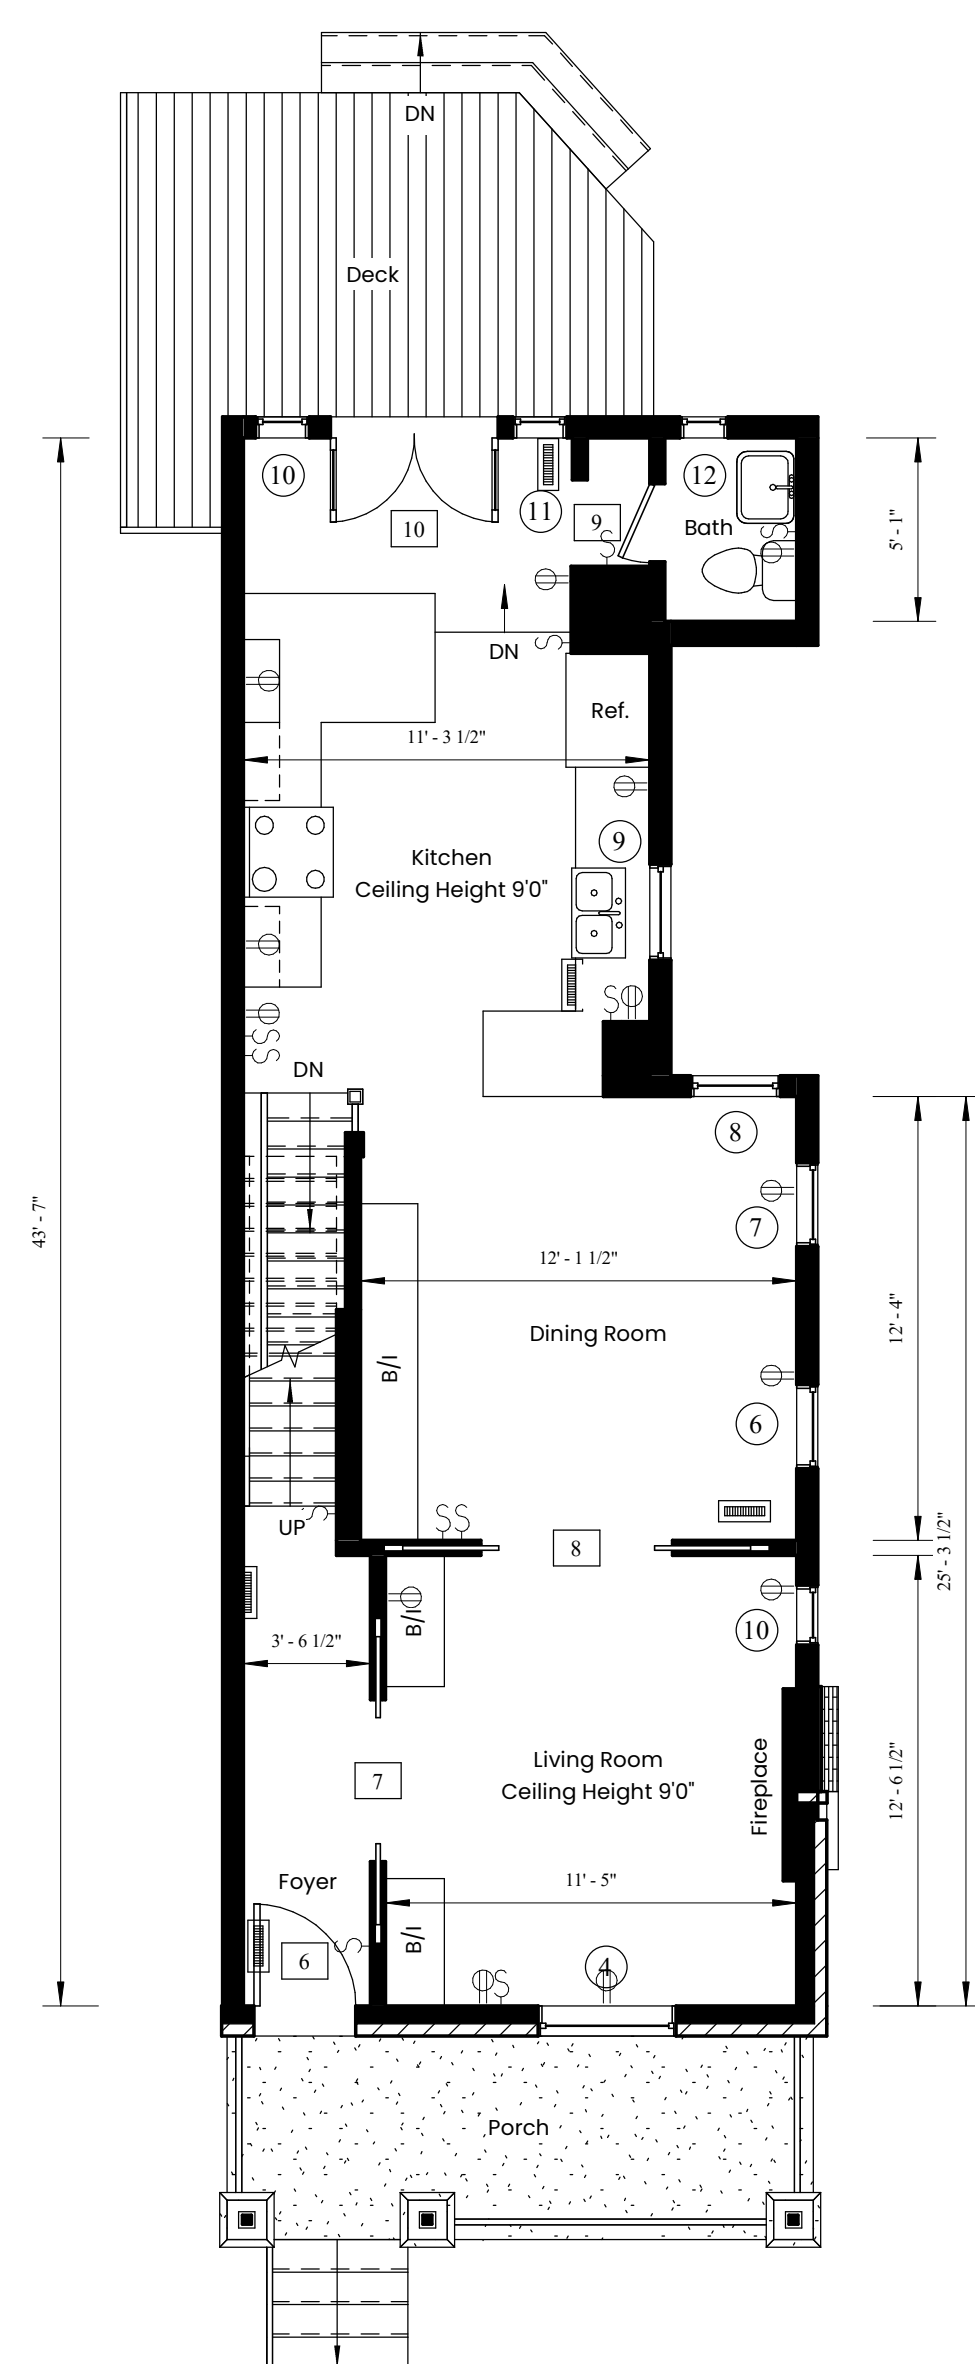


2 A Floor 1 (EXISTING)
3/16" = 1'-0"

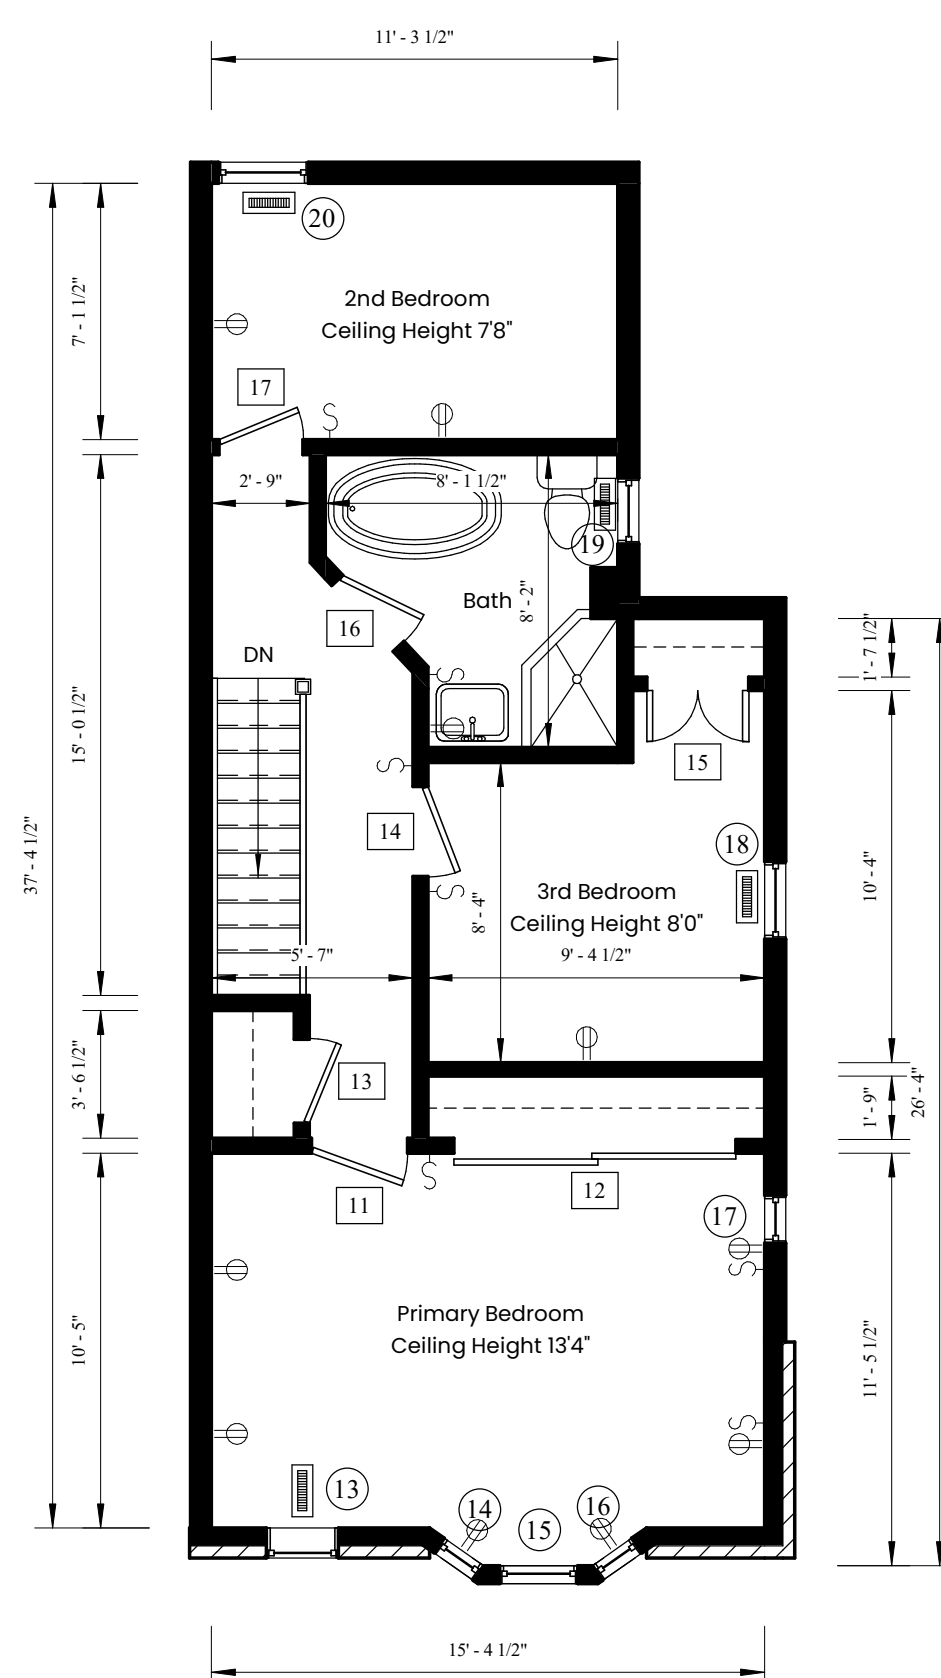


3 A Floor 2 (EXISTING)
3/16" = 1'-0"

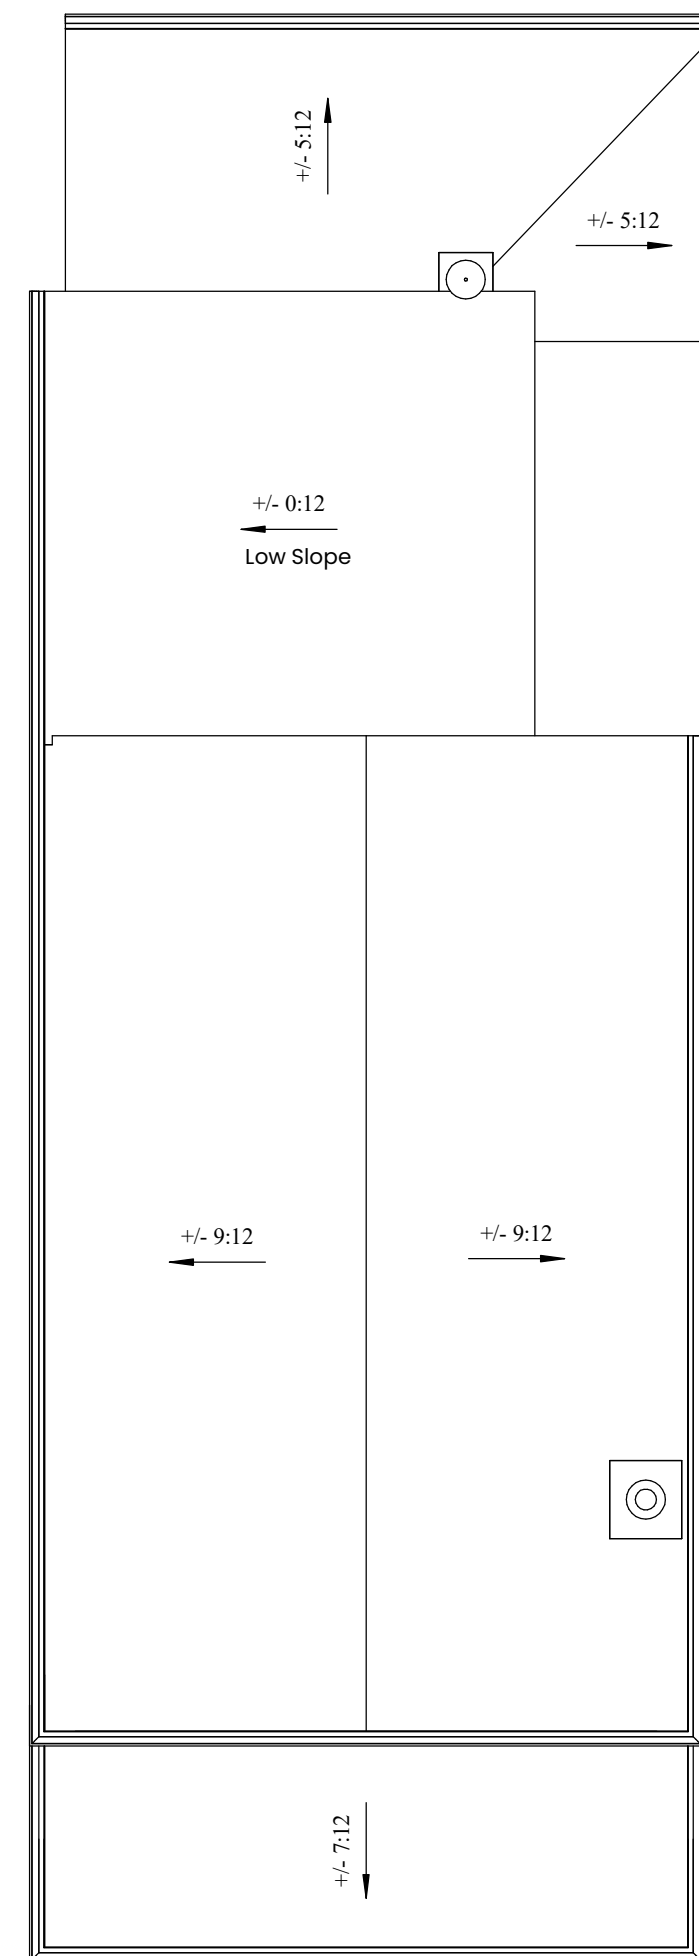

4 A Roof (EXISTING)
3/16" = 1'-0"

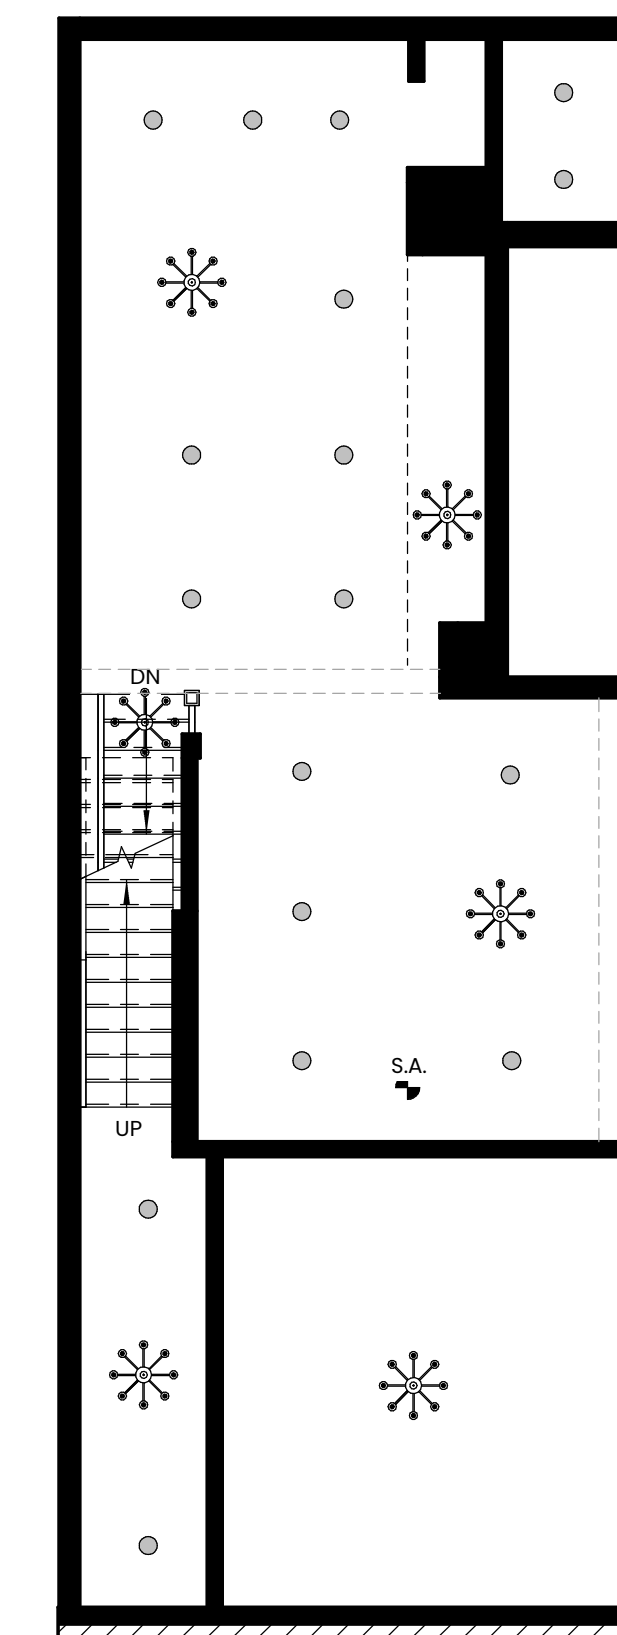



11 A Floor 1 Reflected Ceiling Plan (EXISTING)
3/16" = 1'-0"

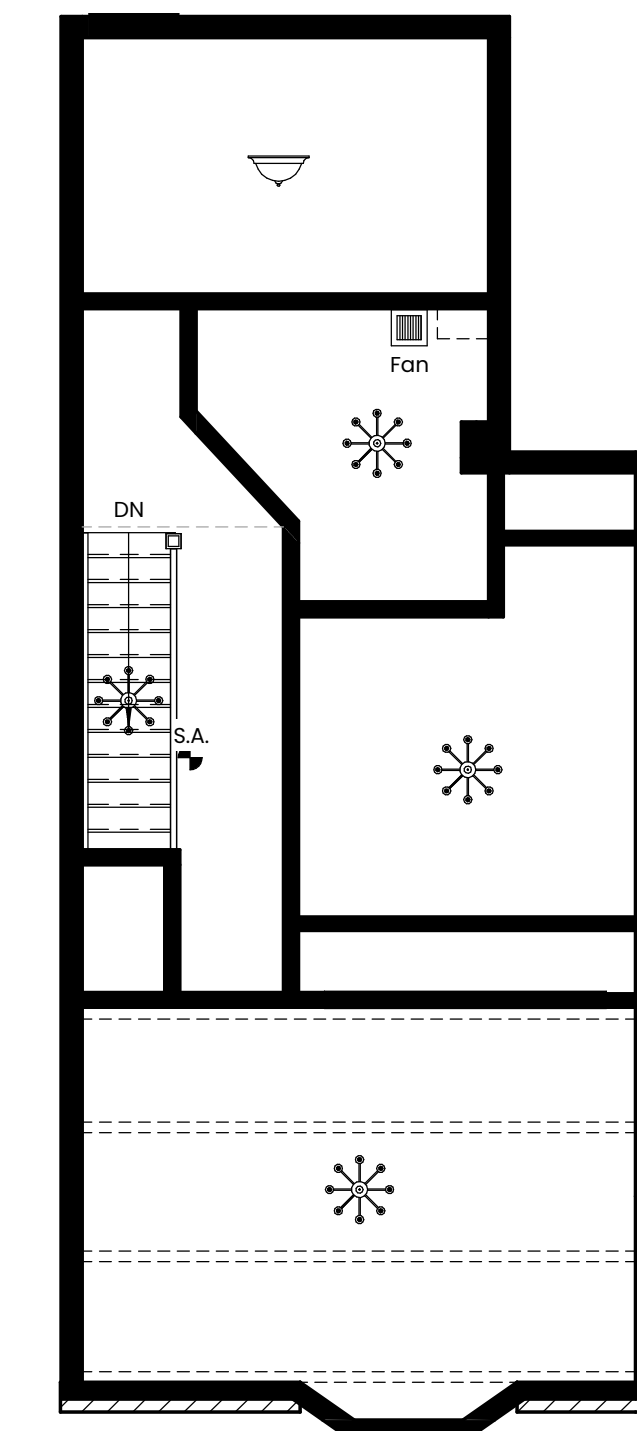

12 A Floor 2 Reflected Ceiling Plan (EXISTING)
3/16" = 1'-0"

Door Schedule (EXISTING - Contractor To Confirm All Dimensions)					
Door Number	Level	Approximate Size		Sill Height	Comments
		Width	Height		
1	Basement	2' - 8"	5' - 8"	0' - 4"	
2	Basement	2' - 2"	6' - 2"	0' - 0"	
3	Basement	2' - 8"	6' - 4"	0' - 0"	
4	Basement	5' - 2"	6' - 4"	0' - 0"	
5	Basement	2' - 0"	6' - 2"	0' - 0"	
6	Floor 1	2' - 10"	6' - 10"	0' - 0"	
7	Floor 1	4' - 6"	6' - 8"	0' - 0"	
8	Floor 1	5' - 4"	6' - 8"	0' - 0"	
9	Floor 1	2' - 2"	6' - 8"	-0' - 5"	
10	Floor 1	4' - 8"	6' - 8"	-0' - 5"	
11	Floor 2	2' - 8"	6' - 8"	0' - 0"	
12	Floor 2	7' - 10"	6' - 8"	0' - 0"	
13	Floor 2	2' - 4"	6' - 8"	0' - 0"	
14	Floor 2	2' - 6"	6' - 8"	0' - 0"	
15	Floor 2	2' - 10"	6' - 8"	0' - 0"	
16	Floor 2	2' - 6"	6' - 8"	0' - 0"	
17	Floor 2	2' - 4"	6' - 8"	0' - 0"	

Window Schedule (EXISTING - Contractor To Confirm All Dimensions)					
Window Number	Level	Approximate Size		Sill Height	Comments
		Width	Height		
1	Basement	2' - 0"	1' - 10"	4' - 9"	
2	Basement	2' - 4"	1' - 4"	5' - 2"	
3	Basement	3' - 0"	1' - 4"	4' - 9"	
4	Floor 1	3' - 10"	5' - 4"	2' - 2"	
6	Floor 1	2' - 4"	3' - 0"	4' - 2"	
7	Floor 1	2' - 4"	3' - 0"	4' - 2"	
8	Floor 1	2' - 6"	3' - 0"	4' - 2"	
9	Floor 1	2' - 8"	3' - 0"	4' - 5"	
10	Floor 1	1' - 6"	4' - 0"	2' - 2"	
10	Floor 1	1' - 8"	3' - 0"	4' - 2"	
11	Floor 1	1' - 6"	4' - 0"	2' - 2"	
12	Floor 1	1' - 4"	2' - 4"	4' - 1"	
13	Floor 2	2' - 0"	1' - 10"	4' - 0"	
14	Floor 2	1' - 4"	4' - 10"	1' - 11"	
15	Floor 2	2' - 2"	4' - 10"	1' - 11"	
16	Floor 2	1' - 4"	4' - 10"	1' - 11"	
17	Floor 2	1' - 4"	3' - 0"	3' - 8"	
18	Floor 2	2' - 2"	5' - 0"	1' - 6"	
19	Floor 2	1' - 10"	3' - 10"	2' - 9"	
20	Floor 2	2' - 6"	5' - 0"	1' - 11"	

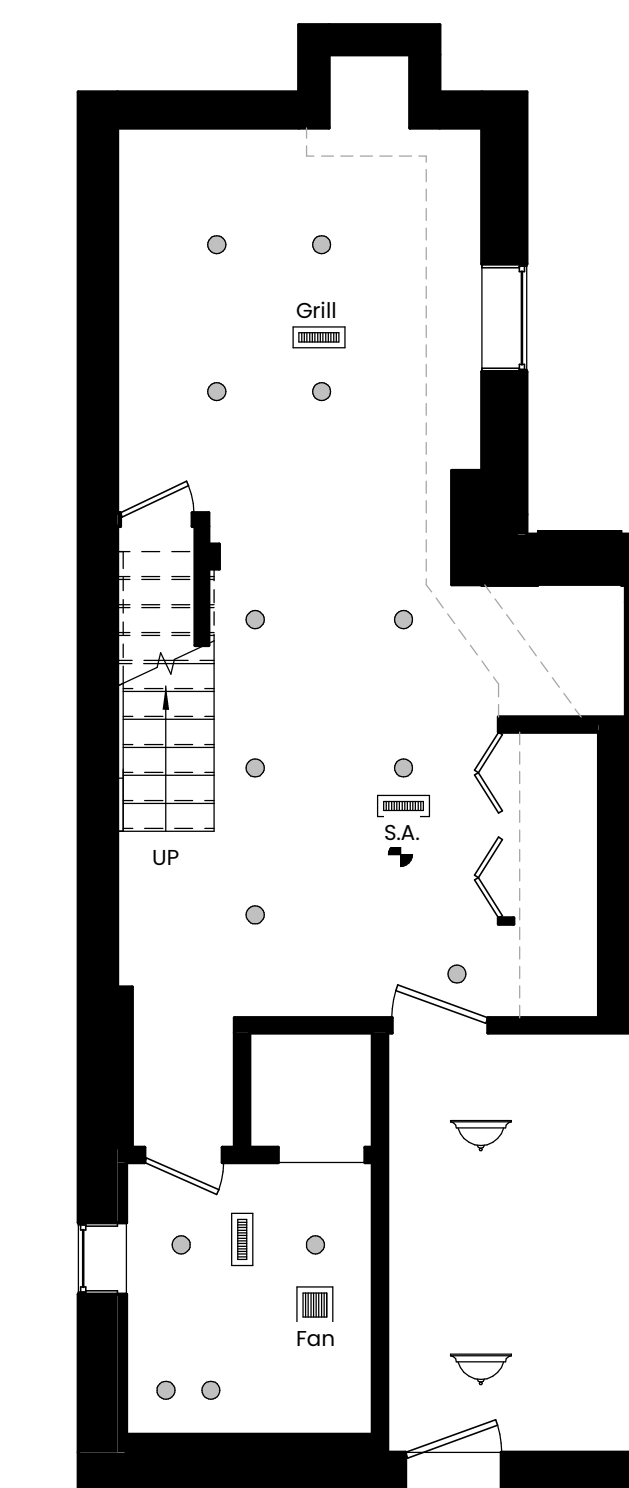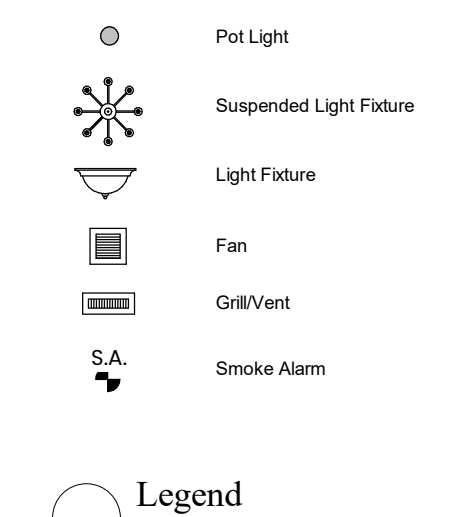

10 A Basement Reflected Ceiling Plan (EXISTING)
3/16" = 1'-0"




Title Existing Floor Plans, Ceiling Plans & Data

Client Dason Residence


Project Number 210620
Address 257 Salem Ave, Toronto
Date July 10, 2021
Drawn By CM
Checked By LM

Scale 3/16" = 1'-0"
A-1


This work product has been prepared by UNIQ Dimensions pursuant to a contract with the Client for the sole benefit and use by the Client. No third party may rely on this work product without the receipt of a reliance letter from UNIQ Dimensions. Measurements & Structural Noted Components To Be Field Verified.

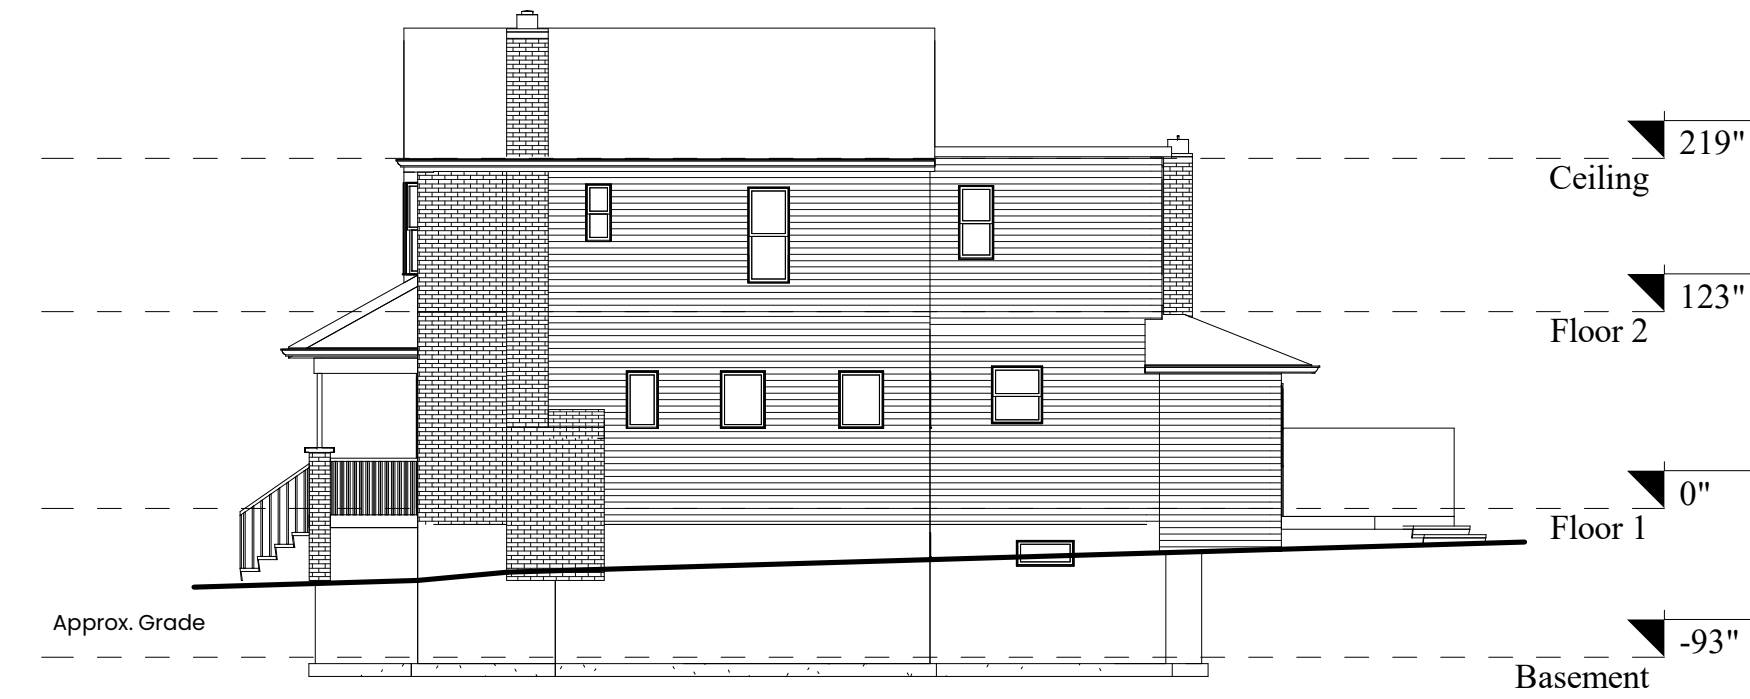


1 East (EXISTING)
1" = 10'-0"

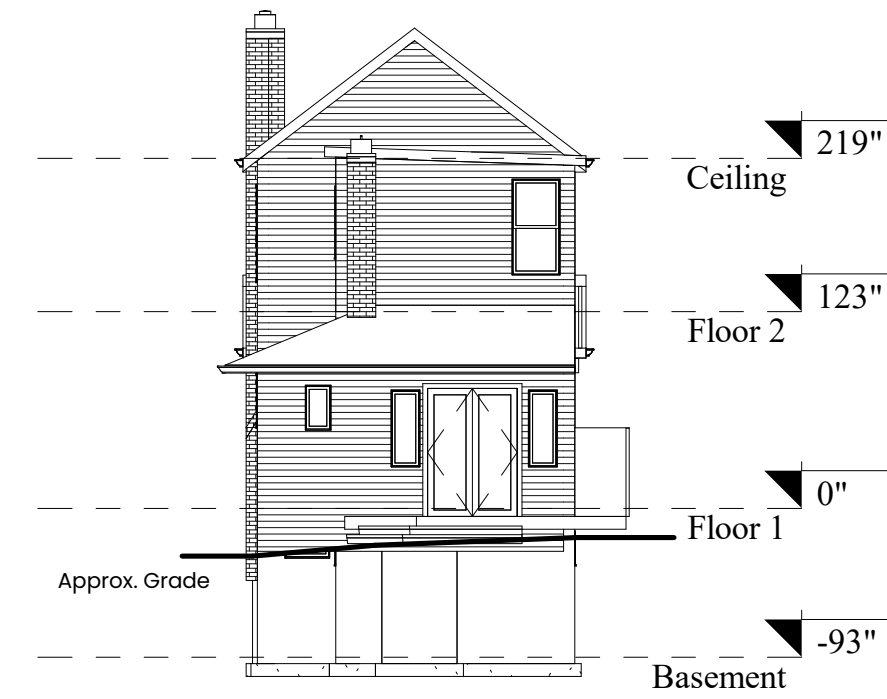


2 North (EXISTING)
1" = 10'-0"

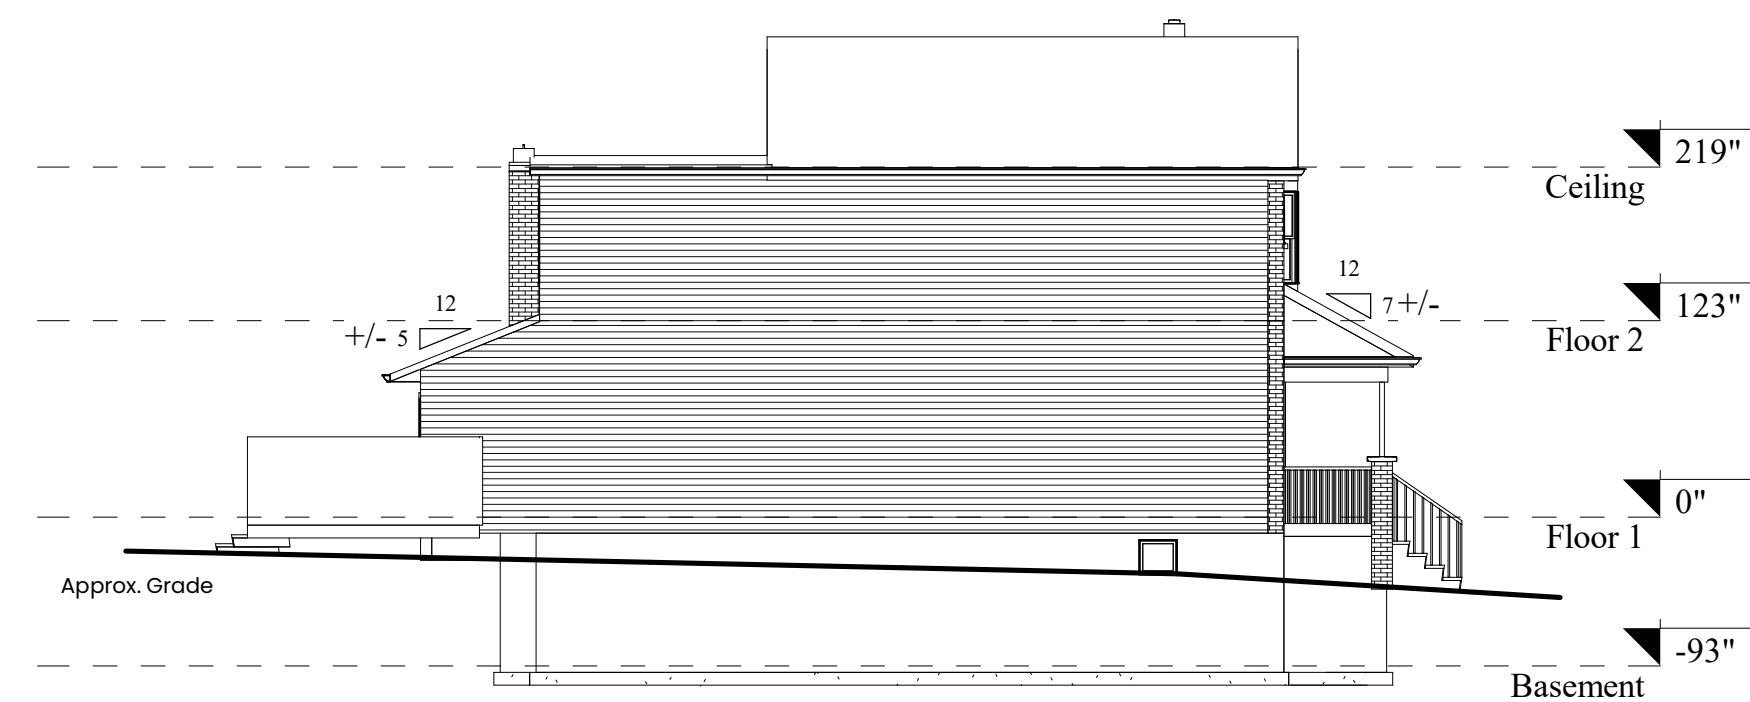

4 West (EXISTING)
1" = 10'-0"

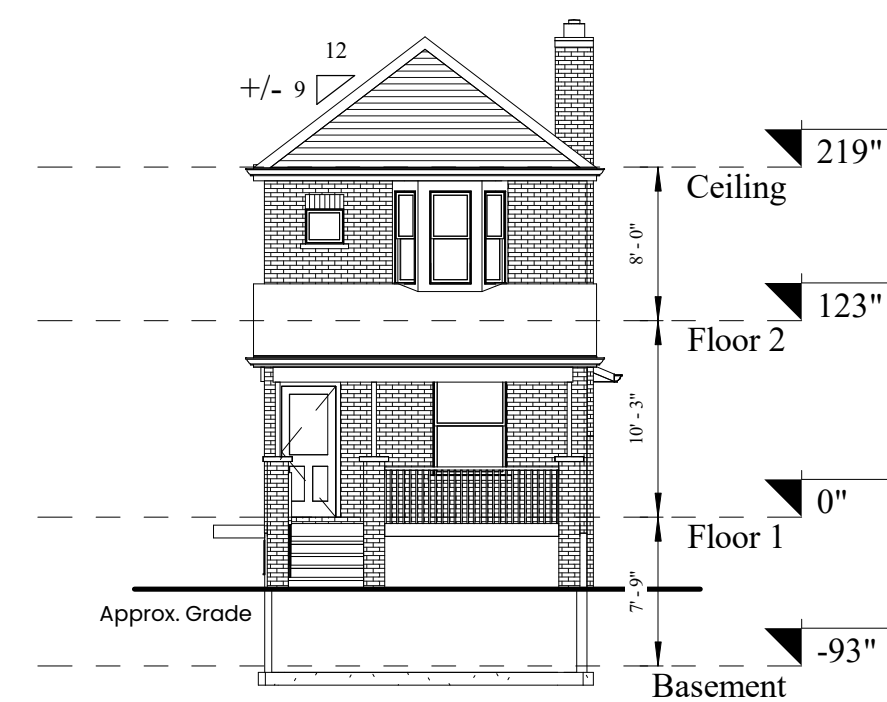

3 South (EXISTING)
1" = 10'-0"

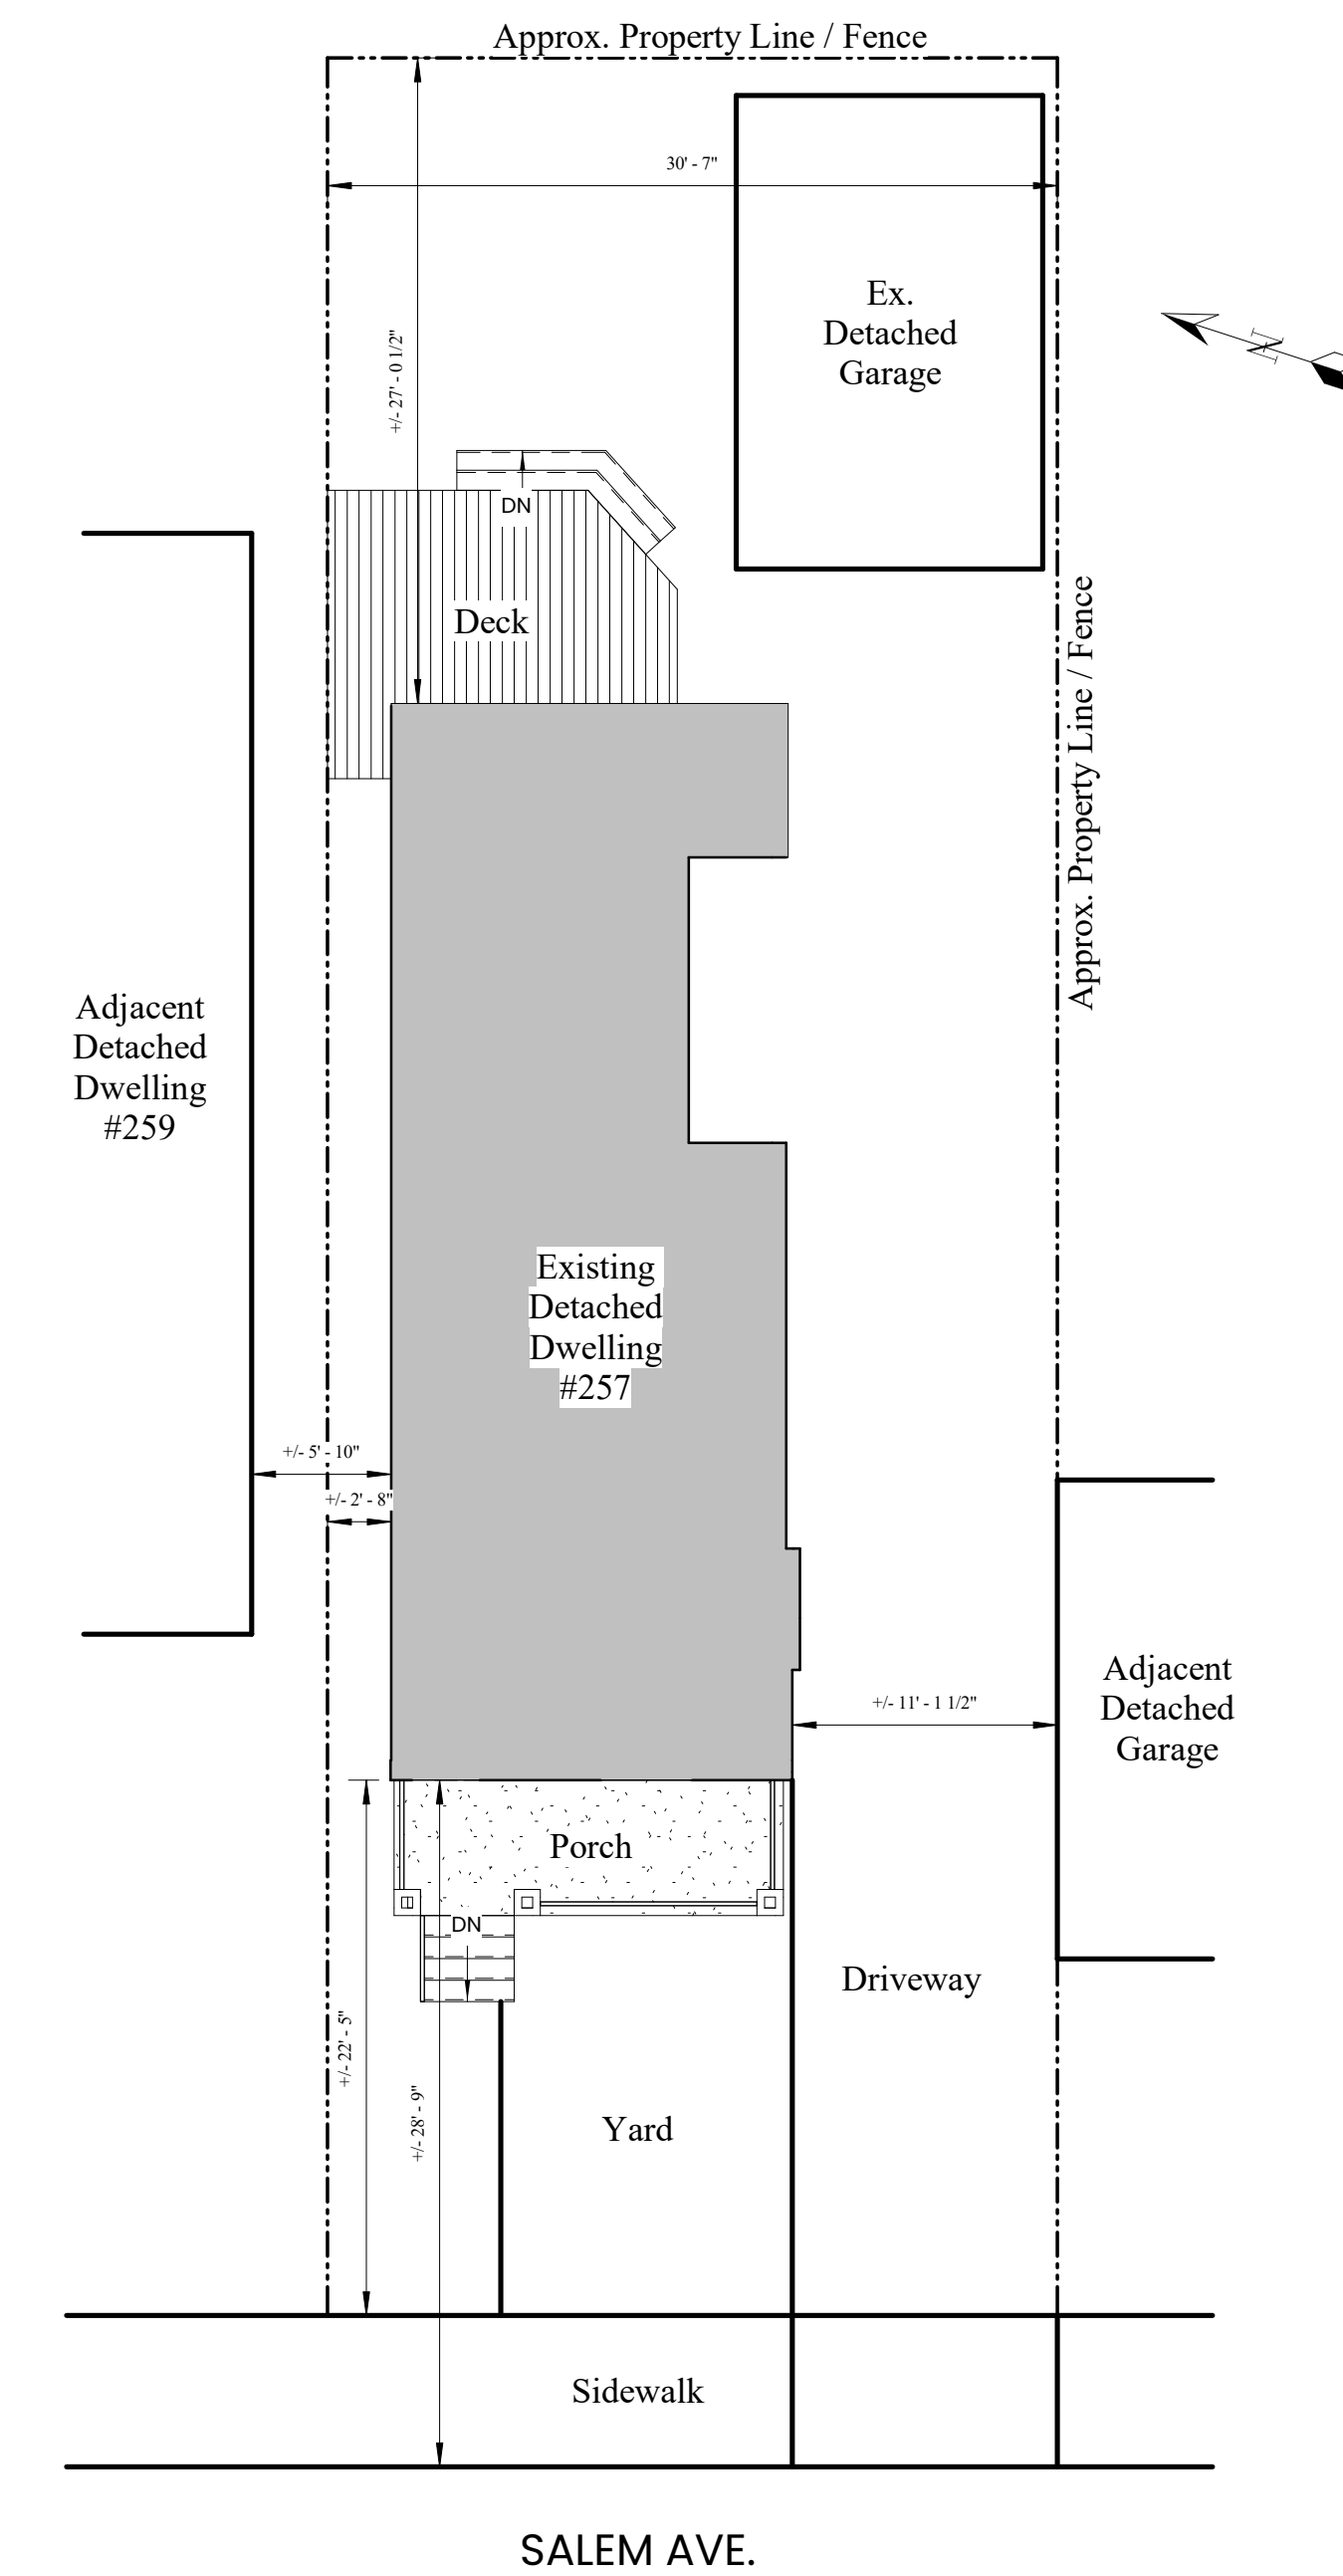

5 Site Plan
1/8" = 1'-0"



Title Existing Exterior Elevations & Site Plan

Client Dason Residence

Project Number	210620	Scale	As indicated
Address	257 Salem Ave, Toronto	A-2	
Date	July 10, 2021		
Drawn By	DC	Checked By	LM

This work product has been prepared by UNIQ Dimensions pursuant to a contract with the Client for the sole benefit and use by the Client. No third party may rely on this work product without the receipt of a reliance letter from UNIQ Dimensions. Measurements & Structural Noted Components To Be Field Verified.